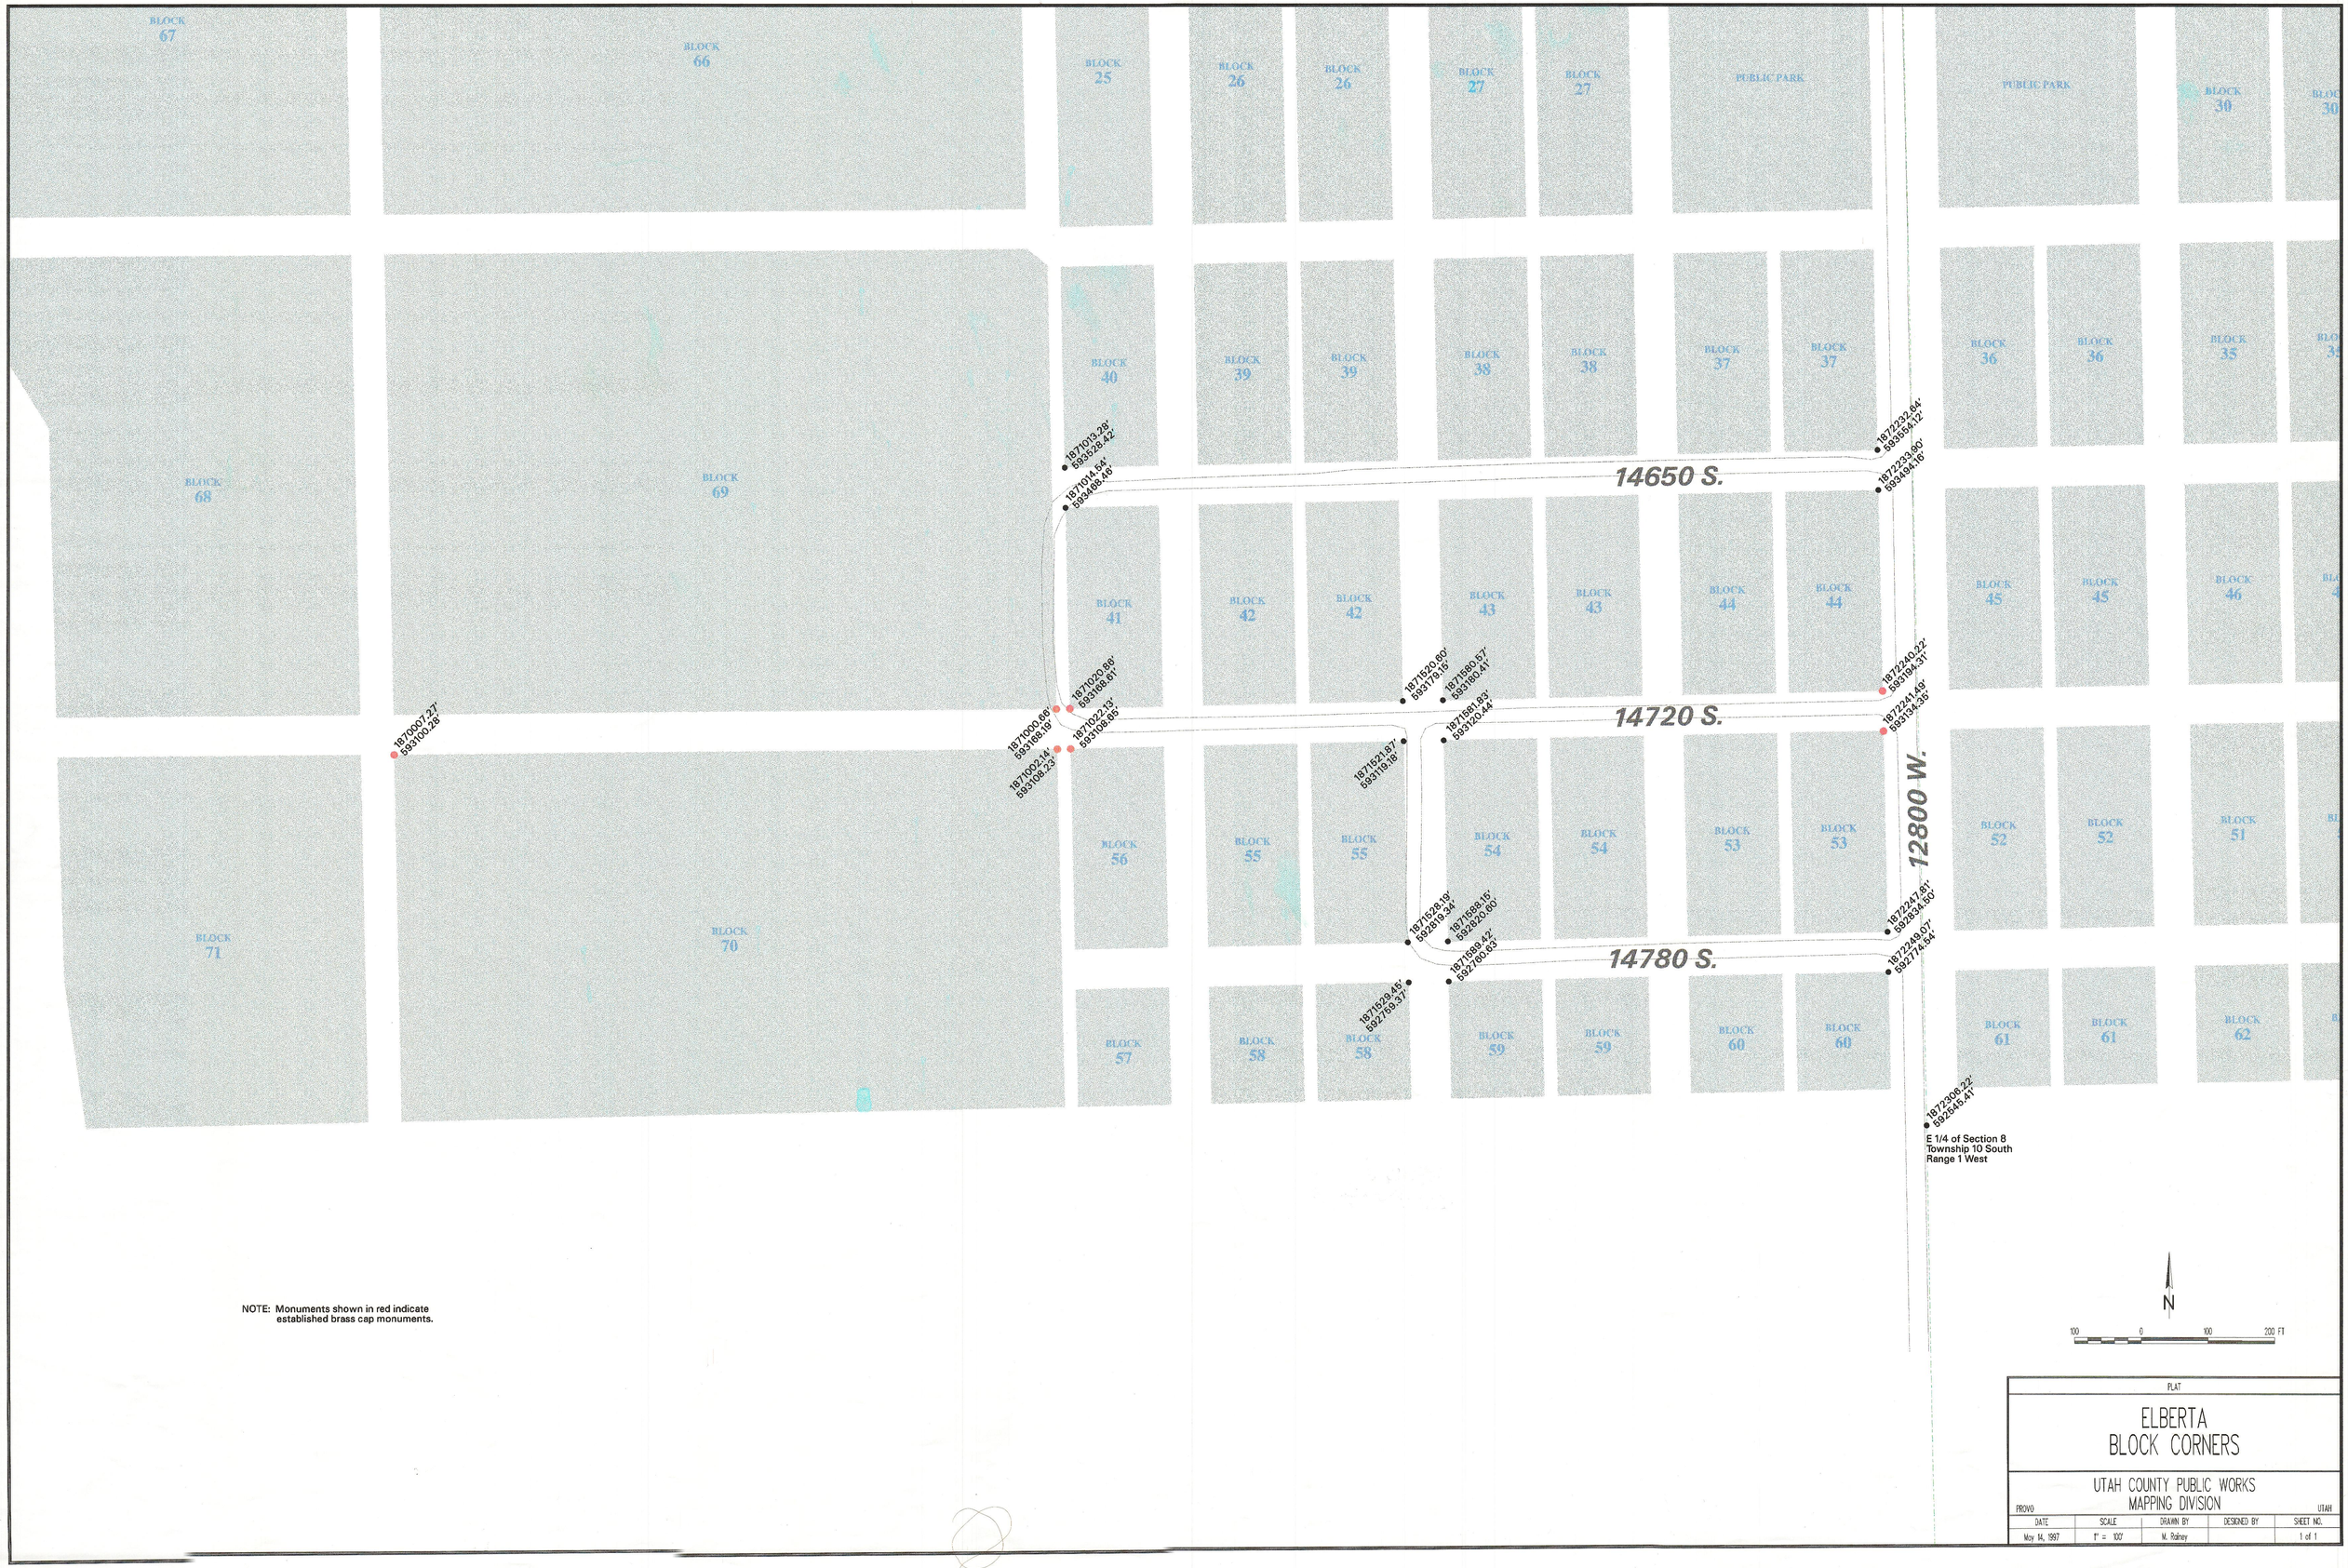

NOTE: Monuments shown in red indicate established brass cap monuments.

PLAT

ELBERTA BLOCK CORNERS

UTAH COUNTY PUBLIC WORKS
MAPPING DIVISION

PROVO UTAH

DATE	SCALE	DRAWN BY	DESIGNED BY	SHEET NO.
May 14, 1997	1" = 100'	M. Rainey		1 of 1